
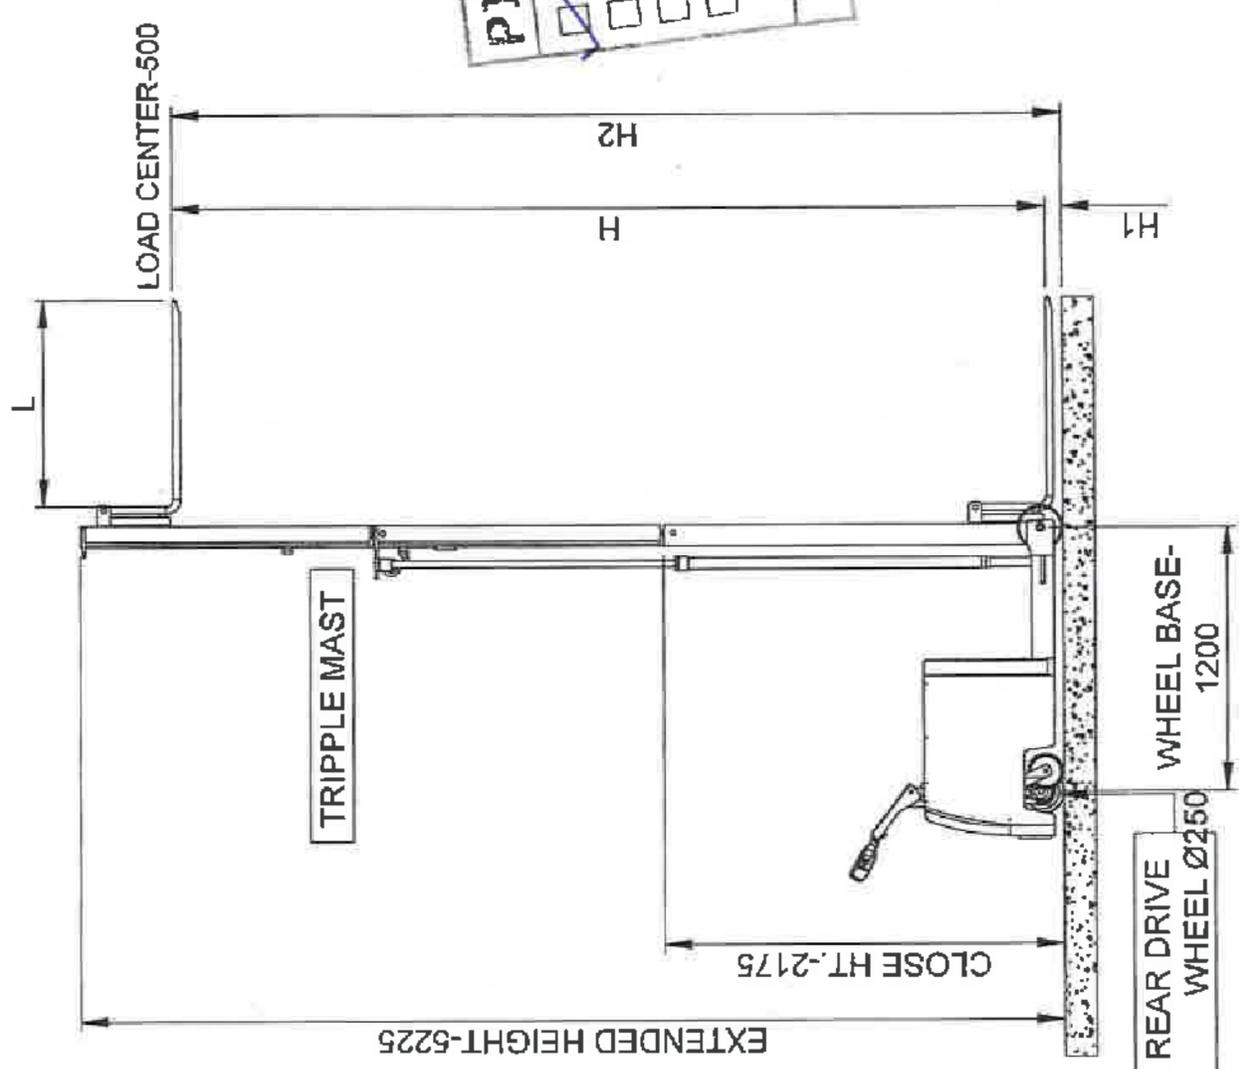


1	2	3	4	5	6	7	8
A	B	C	D	E	F		
IF IN DOUBT PL ASK!	OVER ALL WIDTH -1100	OVER ALL LENGTH-3000	LOAD CENTER-500	TRIPPLE MAST	EXTENDED HEIGHT-5225	CLOSE HT.-2175	WHEEL Ø250
							WHEEL BASE-1200
01	CAPACITY	C	1500 KGS				
02	FORK LENGTH	L	1000				
03	OVERALL FORK WIDTH	W	700				
04	BATTERY V/AH	24/227	AMAR RAJA				
05	MIN HEIGHT	H1	90				
06	MAXIMUM HEIGHT	H2	4500				
07	THIS IS SCHEMATIC REPRESENTATION ONLY, ACTUAL MACHINE MAY VARY SLIGHTLY						
08	LOAD CAPACITY						
	1500Kg-500mm						
	1200Kg-1000mm						
	900Kg-2000mm						
	600Kg-3000mm						
	400Kg-4500mm						
09	TURNING REDIUS-1800 mm						
	3D VIEW ONLY FOR REF.						
	PI INDUSTRIES LTD.						
	<input checked="" type="checkbox"/> APPROVED						
	<input type="checkbox"/> Approved Subject to Changes made						
	<input type="checkbox"/> Approved & Resubmit						
	<input type="checkbox"/> Revise & Resubmit						
	<input type="checkbox"/> Not approved						
	Date 15/10/2015 Sign. <i>[Signature]</i>						
	3D VIEW ONLY FOR REF.						
	CUSTOMER-	JOIST-O-MECH					
		(SINCE 1987)					
	TITLE	BATTERY OPERATED					
		COUNTER BALANCE STACKER					
	DRAWING NO.	Q-250825-01					
	SHEET NO.	1-1					
	REV.	RO					
	ALL DIMENSIONS ARE IN mm. AM	CO.NO	PRODUCT NO.				
		DRAWN	G.S.P	06.09.25			
		CHECKED	A.P	06.09.25			
		APPROVED	R.A	06.09.25			
		SCALE:	NTS				

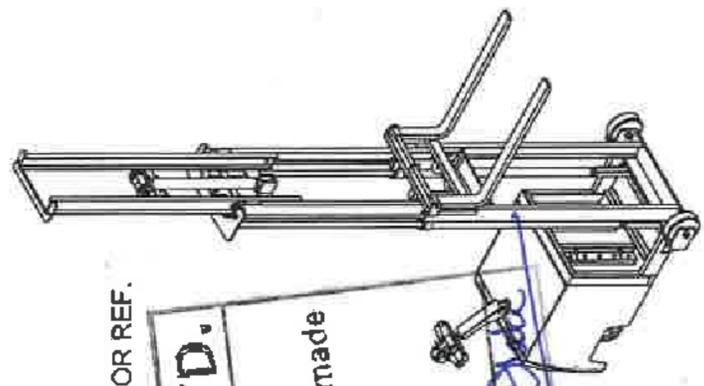

PI INDUSTRIES LTD.  
 APPROVED  
 Approved Subject to Changes made  
 Approved & Resubmit  
 Revise & Resubmit  
 Not approved  
 Date 15/10/2015 Sign. *[Signature]*